


APPENDIX III

TOPOGRAPHICAL PLAN

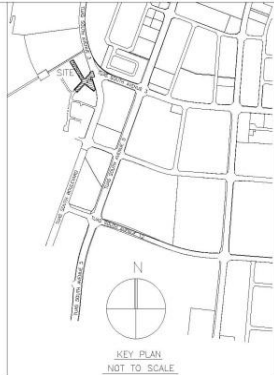

NOTE

- This plan is prepared for Lam Chuan Construction Pte Ltd in July 2014.
- Boundaries shown herein are provisional and subject to final survey.
- Horizontal control were based on SVY21 datum.
- Vertical control were based on VCP80381 at Tuas South Avenue 8 / Avenue 7.
- Trees are verified under our best knowledge and should be verified by a tree specialist when needed.
- Date of survey : April 2014

Building and Construction Authority
Building and Construction Authority
5 Maxwell Road
#16-00 Tower Block MND Complex
Singapore 069110

Lam Chuan Construction Pte Ltd
18 Boon Lay Way #09-121
TradeHub 21 Singapore 609966
Tel: 68990990 / Fax: 68971516
E-Mail: admin@lamchuan.com.sg

BS Registered Surveyor
3 Soon Lee Street
#06-25 Pioneer Junction
Singapore 627606
HP: 90038738 Tel: 66844838 Fax: 66844858
E-Mail: bptsong@gmail.com

ONG BAN SOON
Registered Surveyor (Singapore), M35V
IHO Cat. A, Hydrographic Surveyor

PROJECT TITLE:
PROPOSED DEVELOPMENT OF TUAS CONCRETE
SITE CONSISTING OF CONSTRUCTIONS OF
ROADS, DRAINS, SEWERS, ELECTRICAL
SUBSTATION AND MOT ROOM, LORRY PARK
AND OTHER ANCILLARY WORKS

DRAWING TITLE:
AS-BUILT TOPOGRAPHICAL PLAN
(PHASE 1)

SCALE : 1 : 500	SHEET 1 OF 1	REVISION : C
DRAWN : SH Teo	CHECKED : Ong B S	DATE : 22.07.2014
DRAWING NO : BS/13073/A0/AB/02C		

APPENDIX III

TOPOGRAPHICAL PLAN


(PLOT 1)

The topographical plan for Plot 1 shows a rectangular area with an average level of 105.48m. The plot is bounded by a dashed line. Inside the plot, there are several elevation points marked with numbers, such as 104.78, 104.79, 104.87, 104.88, 104.91, 104.92, 104.93, 109.84, 109.85

APPENDIX III

TOPOGRAPHICAL PLAN


(PLOT 2)

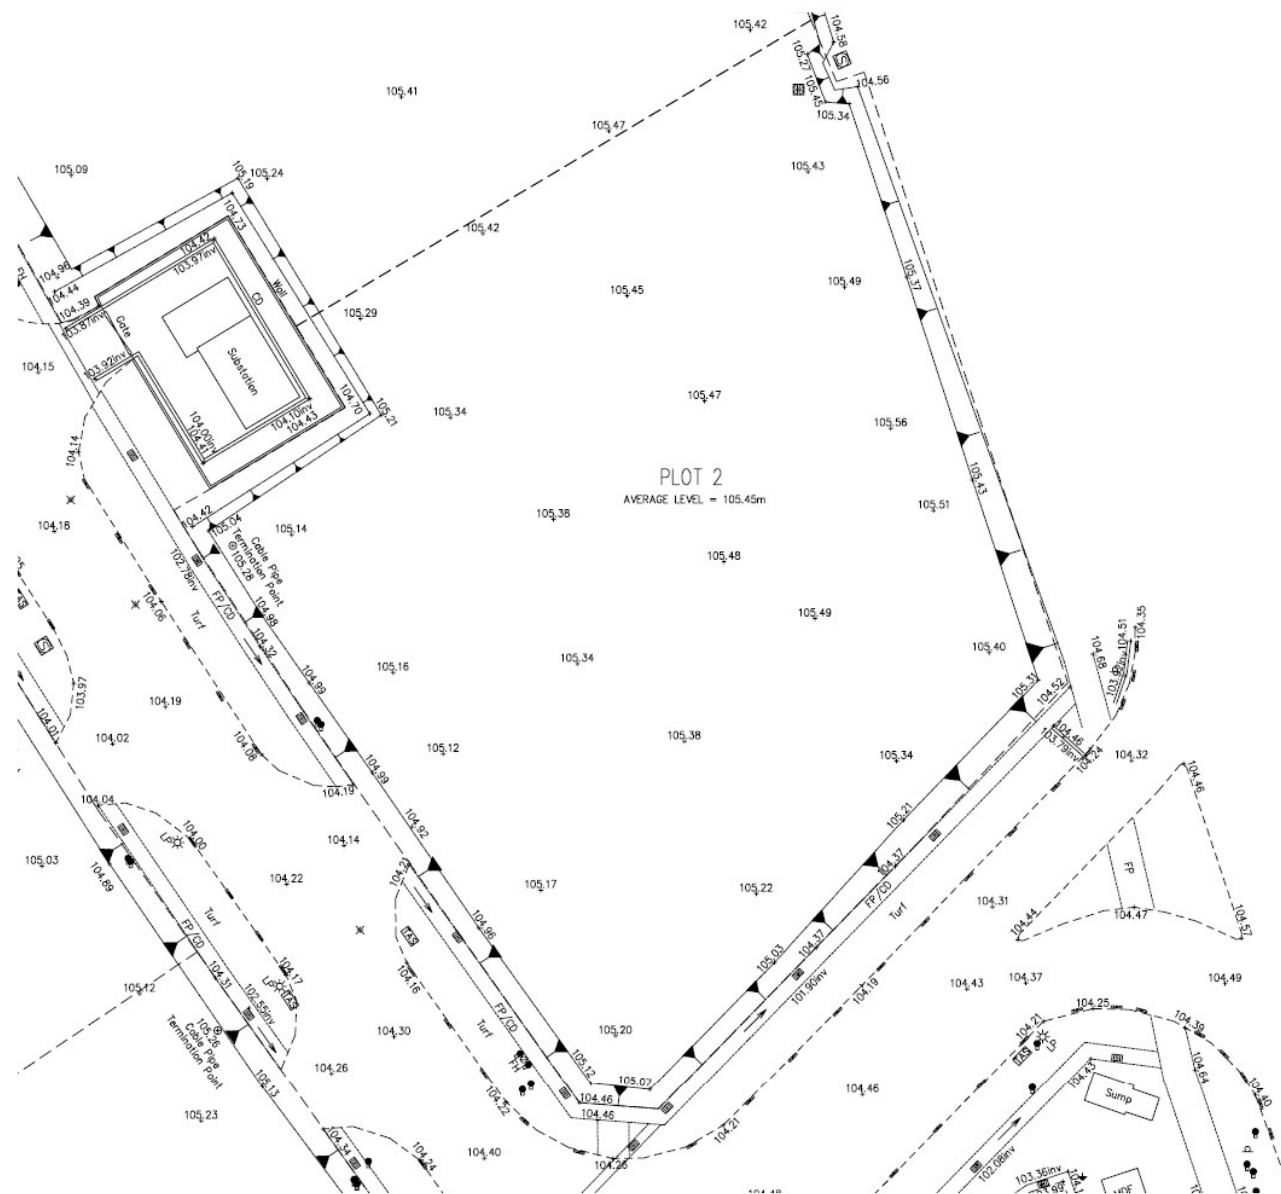

APPENDIX III

TOPOGRAPHICAL PLAN


(PLOT 3)

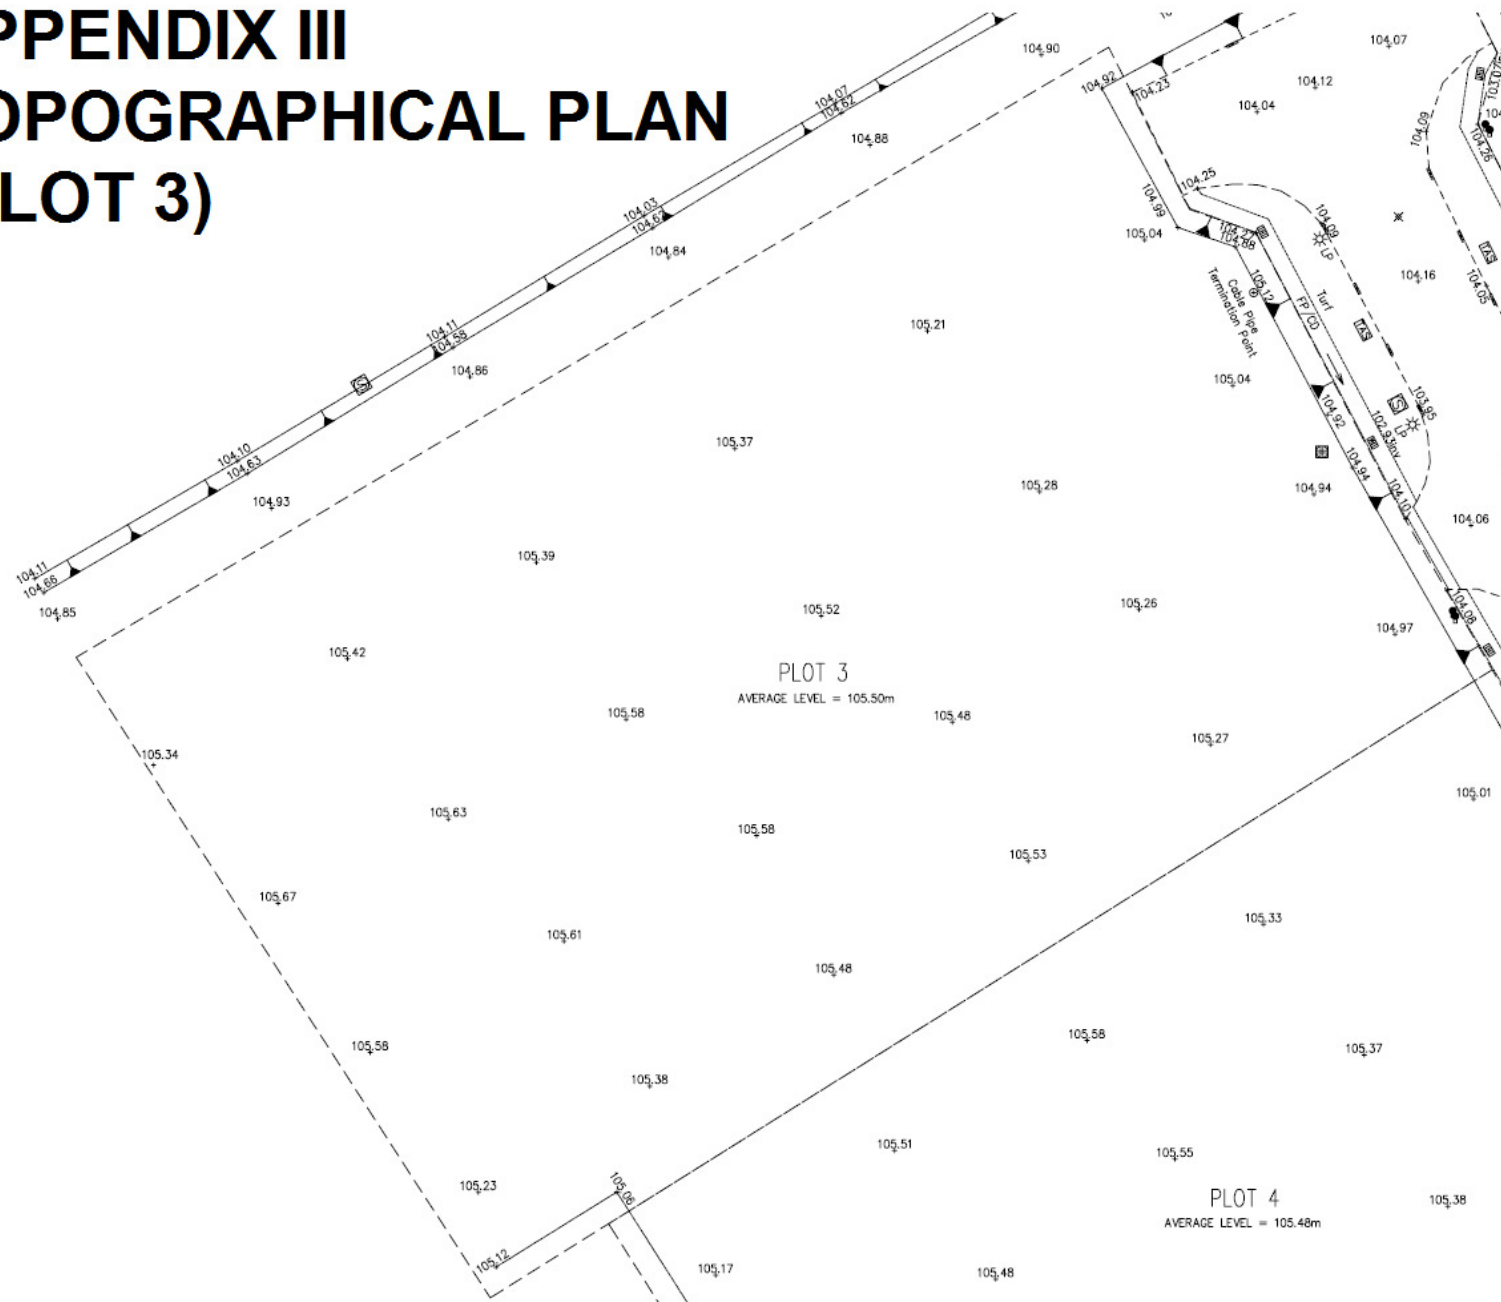

APPENDIX III

TOPOGRAPHICAL PLAN

(PLOT 4)

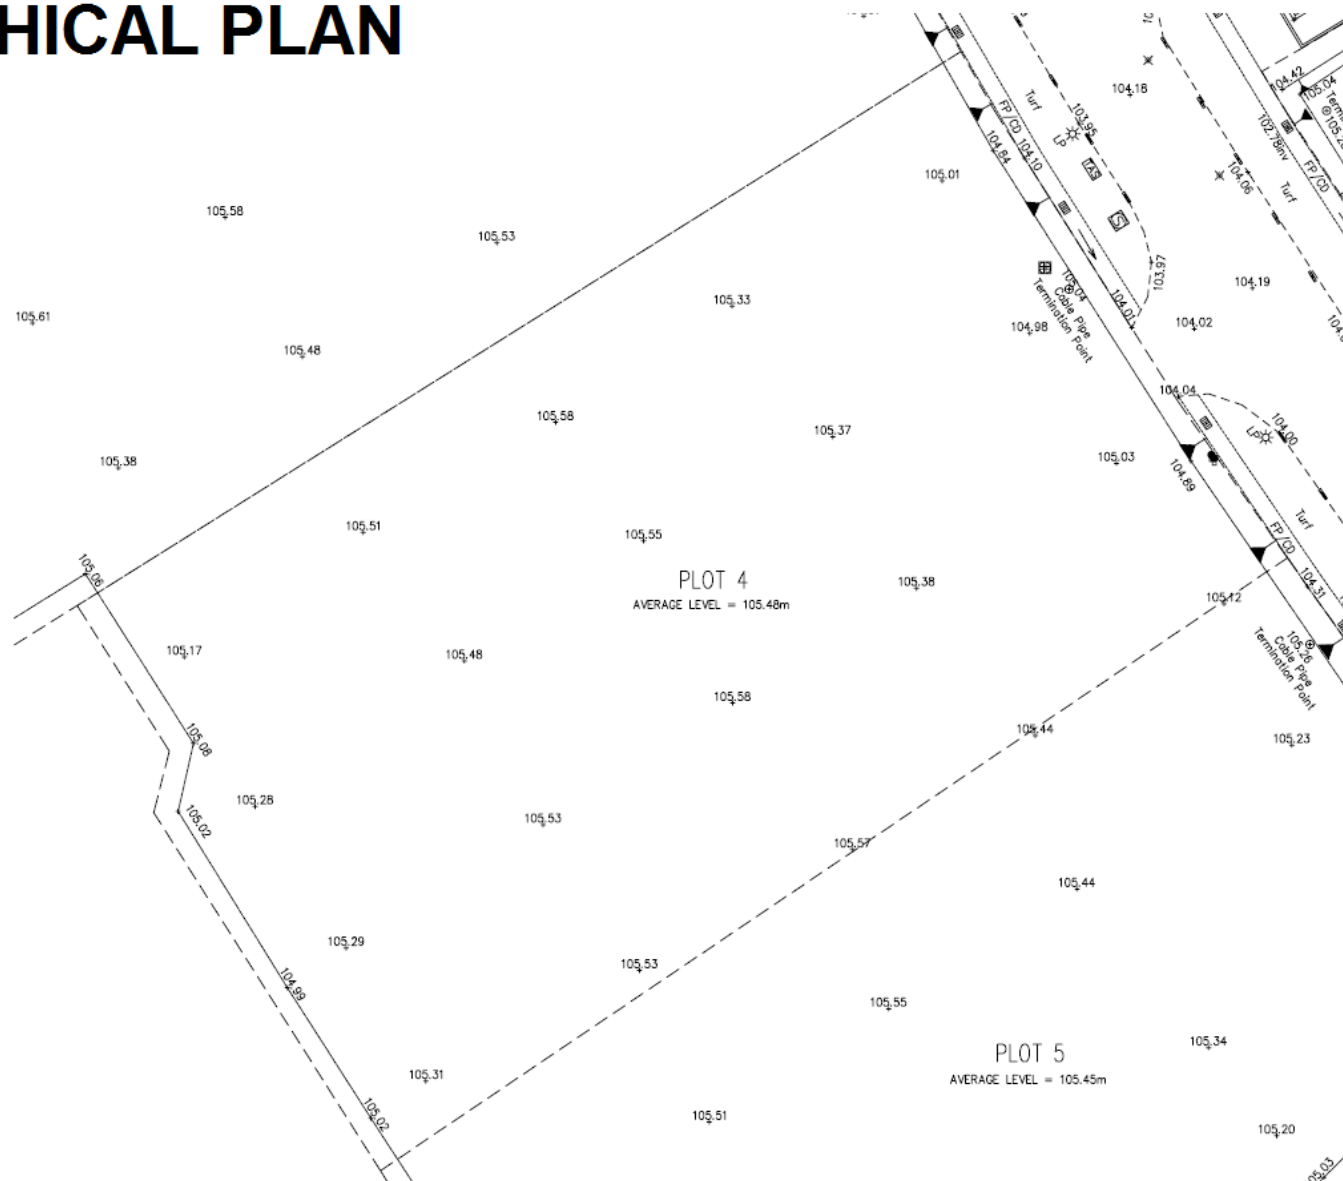

APPENDIX III

TOPOGRAPHICAL PLAN

(PLOT 5)

